




06-Sep-2023 11:59
1 Southgate Business Centre, Bull Lane
London
England
N18 1SX
United Kingdom



06-Sep-2023 12:01
80-96 Bull Lane
London
England
N18
United Kingdom

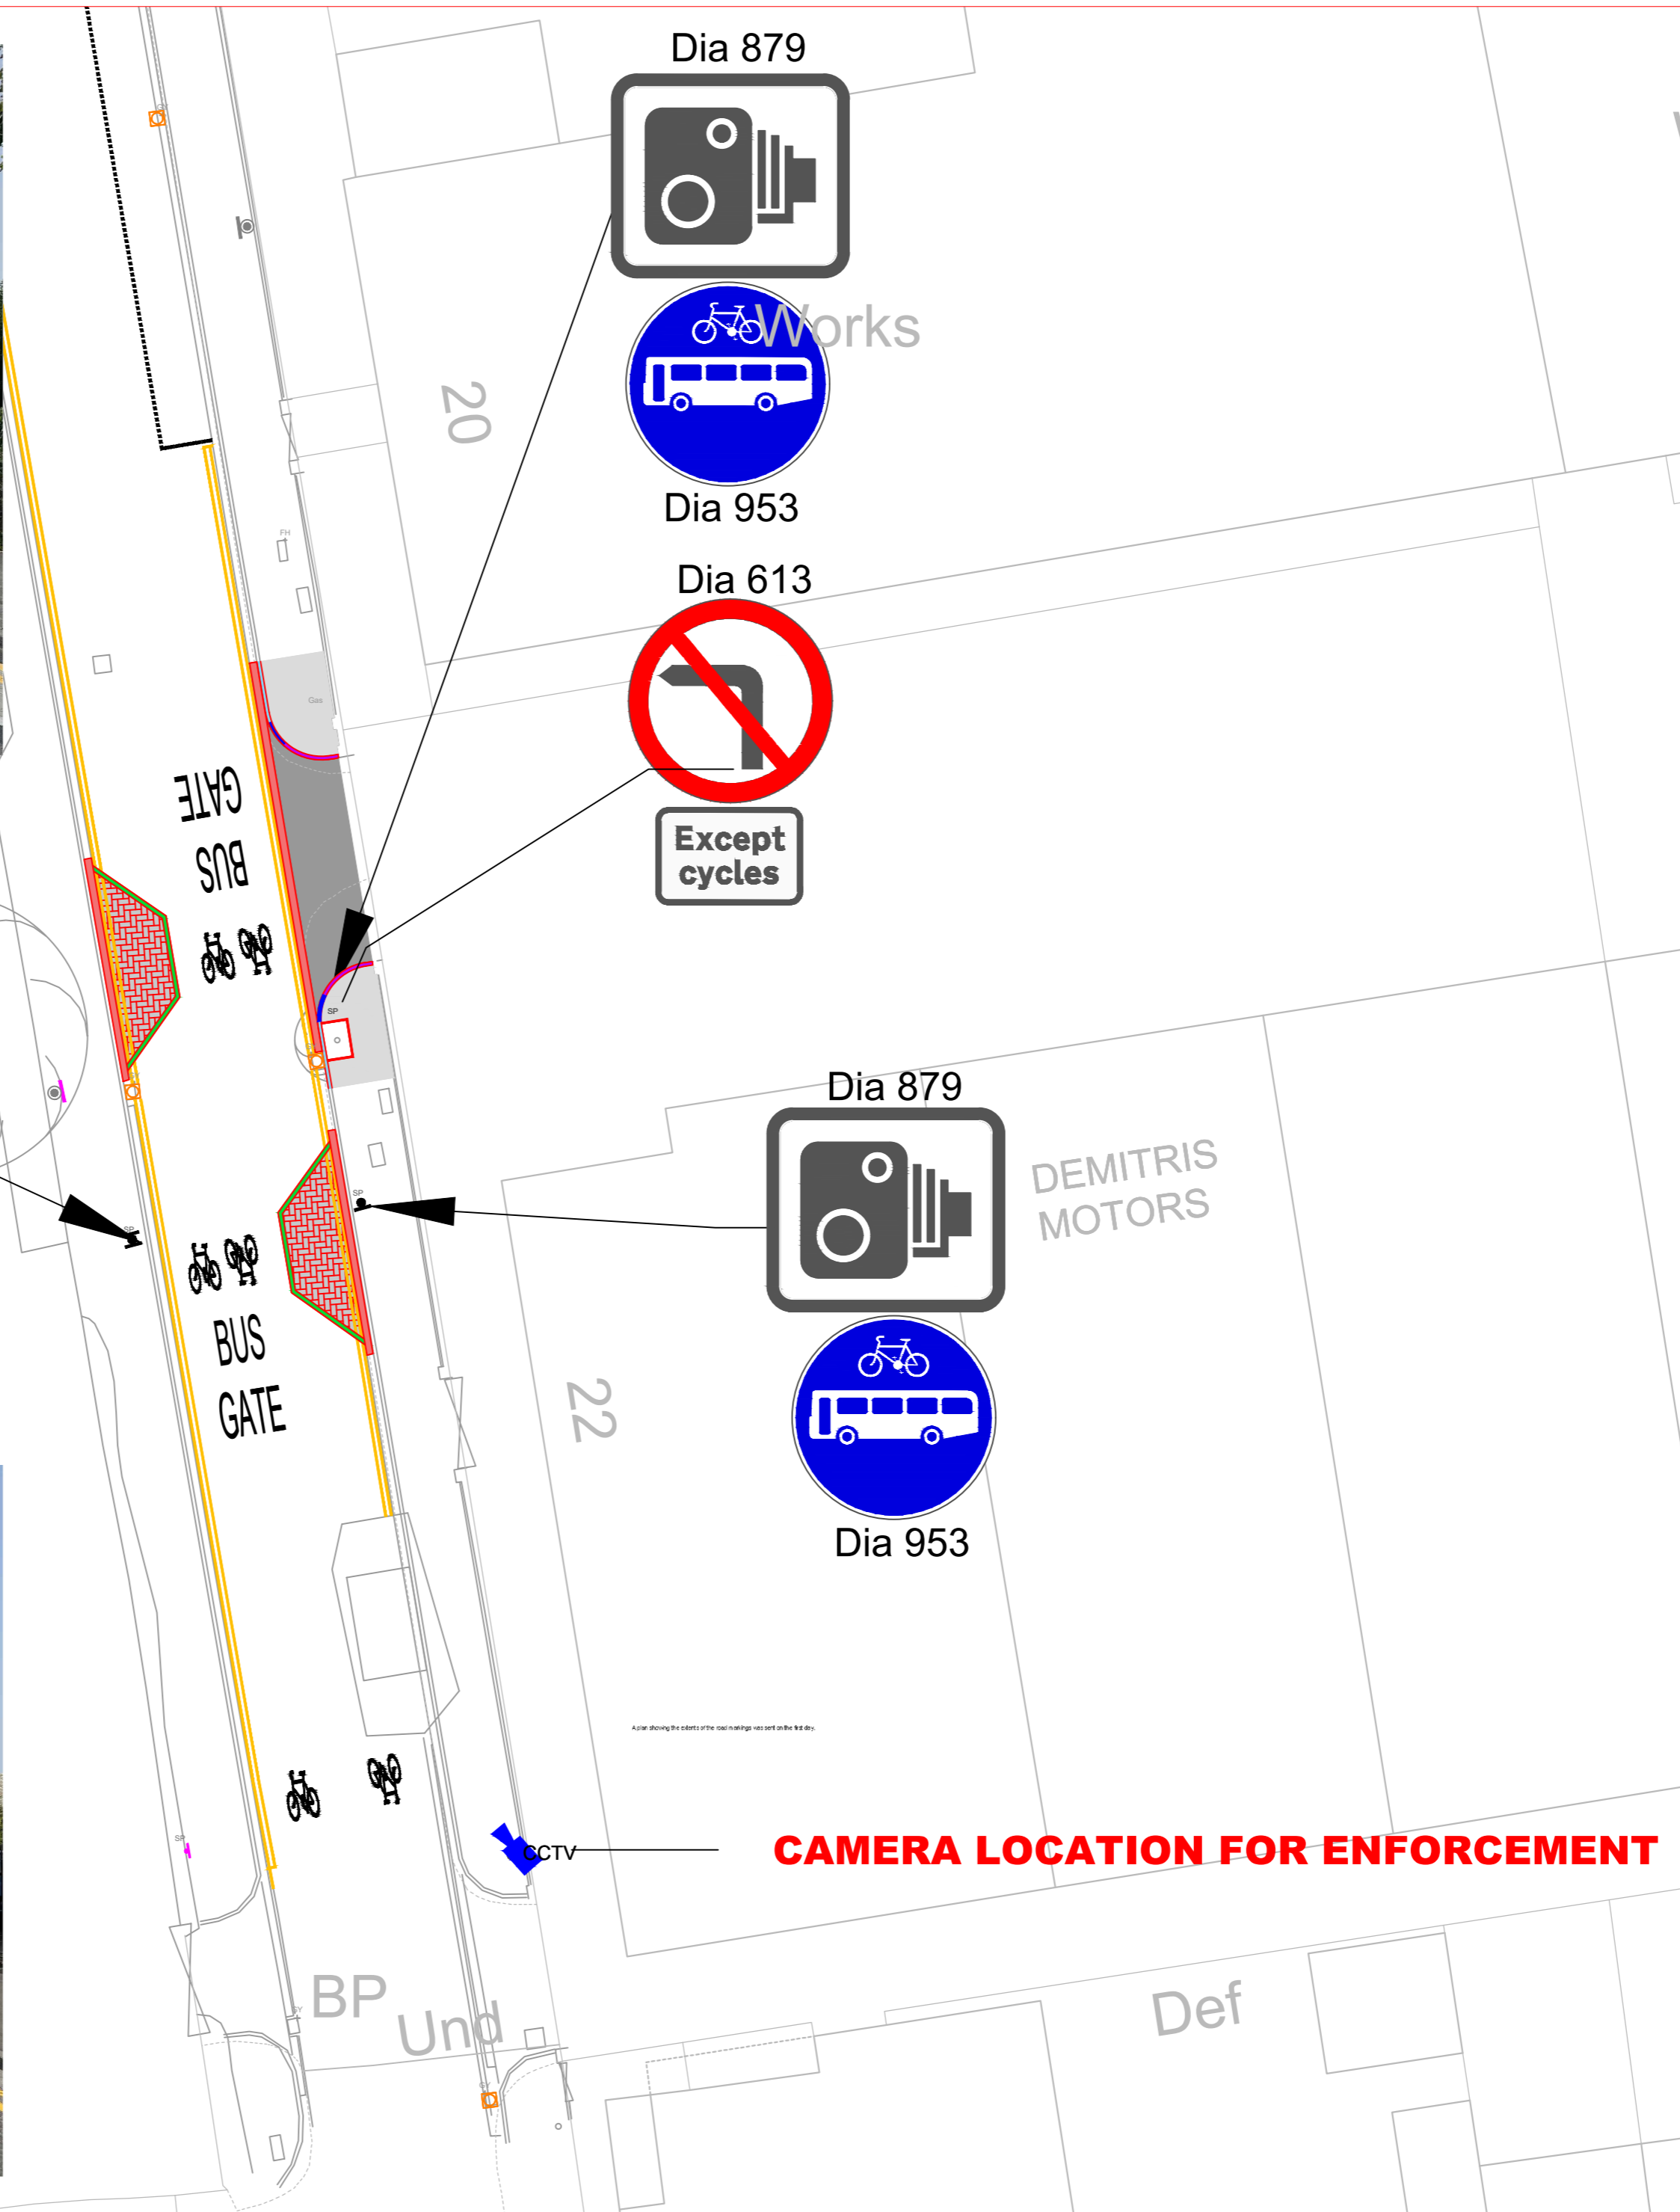

NOTES


1. DO NOT SCALE FROM THIS DRAWING.
2. ANY ERRORS OR OMISSIONS TO BE BROUGHT TO THE ENGINEERS ATTENTION IMMEDIATELY FOUND.
3. ALL DIMENSIONS ARE IN MILLIMETRES UNLESS OTHERWISE SHOWN.
4. ALL LEVELS ARE IN METRES AND RELATE TO ORDNANCE DATUM LEVEL UNLESS NOTED OTHERWISE.
5. THIS DRAWING IS TO BE READ IN CONJUNCTION WITH ALL OTHER DRAWINGS IN THE SAME SERIES.

Rev	Revision details	Date

©CROWN COPYRIGHT. ALL RIGHTS RESERVED. LONDON BOROUGH OF ENFIELD LA 08363. UNAUTHORISED REPRODUCTION OF ORDNANCE SURVEY MAPPING INFRINGES CROWN COPYRIGHT AND MAY LEAD TO PROCEEDINGS.

STATUS	AS BUILT
CLIENT	LONDON BOROUGH OF ENFIELD
JOB TITLE	BULL IANE, N18 BUS GATE

DRAWING TITLE	BULL LANE, N18 BUS GATE ENFORCEMENT PLAN
----------------------	---

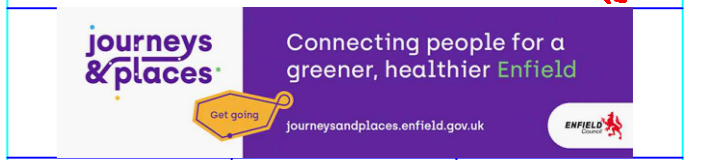

DESIGNED:-	DRAWN:-	DATE:-
	HR	06.09.23
SCALE:-	PLOT SCALE:-	CHECKED:-
1:200	1:1	
DRAWING NO.	BL-BUSGATE-001	